

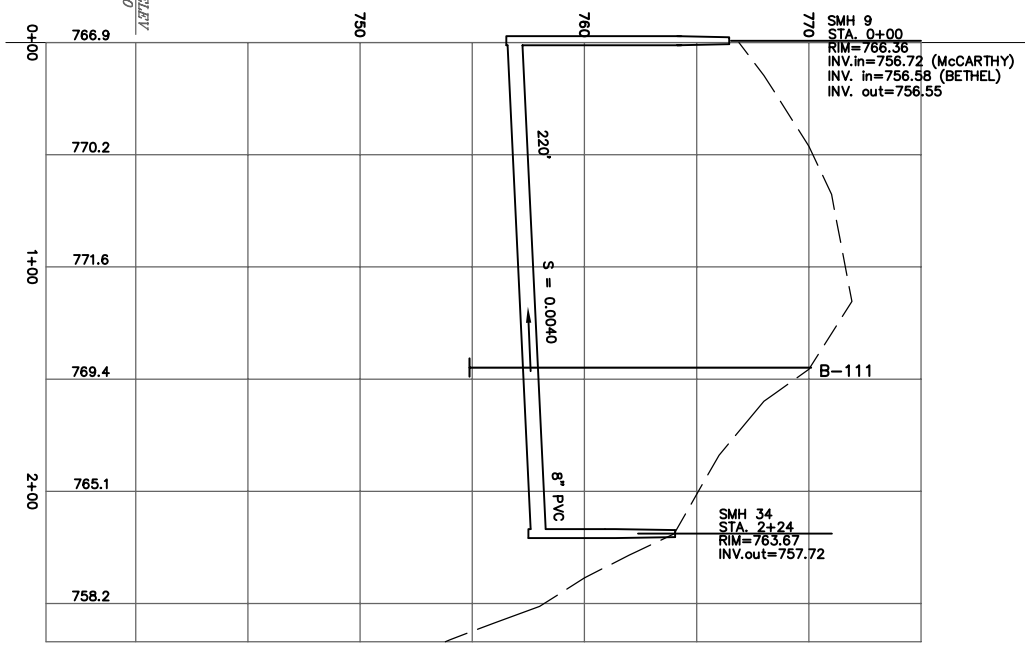


PLAN  
SCALE: 1"=40'

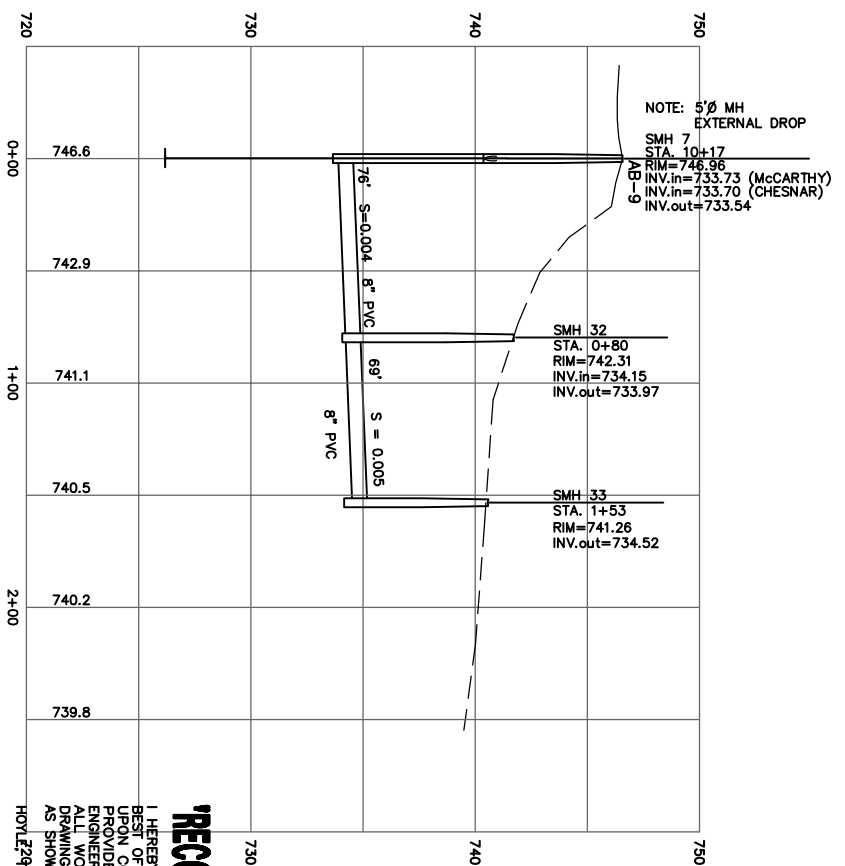

PROFILE  
SCALE: 1"=40' HORIZ.  
1"=4' VERT.

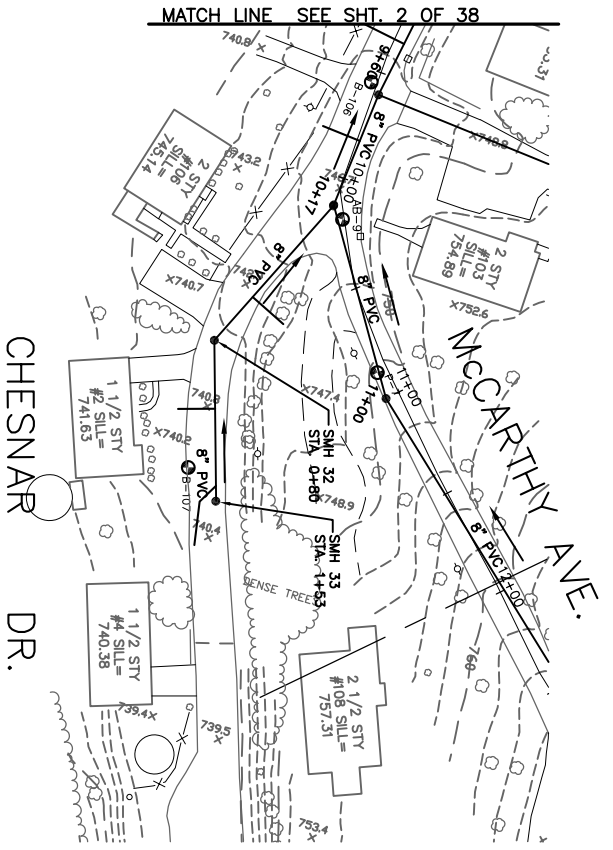


**RECORD DRAWING**

I HEREBY CERTIFY THAT TO THE BEST OF MY KNOWLEDGE AND BELIEF, THE INFORMATION CONTAINED HEREON WAS OBTAINED FROM THE RECORDS PROVIDED BY THE RESIDENT ENGINEER AND THE CONTRACTOR, ALL WORK SHOWN ON THIS DRAWING HAS BEEN COMPLETED AS SHOWN.

HOYLE, TANNER & ASSOCIATES, INC.

**NOTE:**

ALL PROJECT REQUIREMENTS AS SET FORTH ON THIS SHEET HAVE BEEN COMPLIED WITH DURING THE CONSTRUCTION OF THIS PROJECT. THE CONTRACTOR IS NOT RESPONSIBLE FOR ANY ERRORS OR OMISSIONS HEREON IS UNDERSTOOD TO BE PAST TENSE.

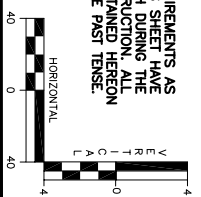

SHEET 9 OF 38	DRAWING NO. <b>9</b>	CHERRY VALLEY SEWER DISTRICT LEICESTER, MASSACHUSETTS		<b>Hoyle, Tanner &amp; Associates, Inc.</b> 150 Dow Street • Manchester • New Hampshire 03101 Consulting Engineers			PROJECT NO. 105709			ENGINEER/ARCHITECT			
		BETHEL AVE. / CHESNAR DR.		SCALE: AS SHOWN	DATE: APRIL 2001	DES. BY JAH	DR. BY CAB/RCP	CHKD. BY NLT	FILE NAME ABPROF-08		1. RECORD DRAWING	C.B. W.C. W.C. 10/02	
							DO NOT SCALE DRAWING	REV.	DESCRIPTION	DR. BY	CHKD. BY	APPD. BY	DATE