



PLAN
SCALE: 1"=40'

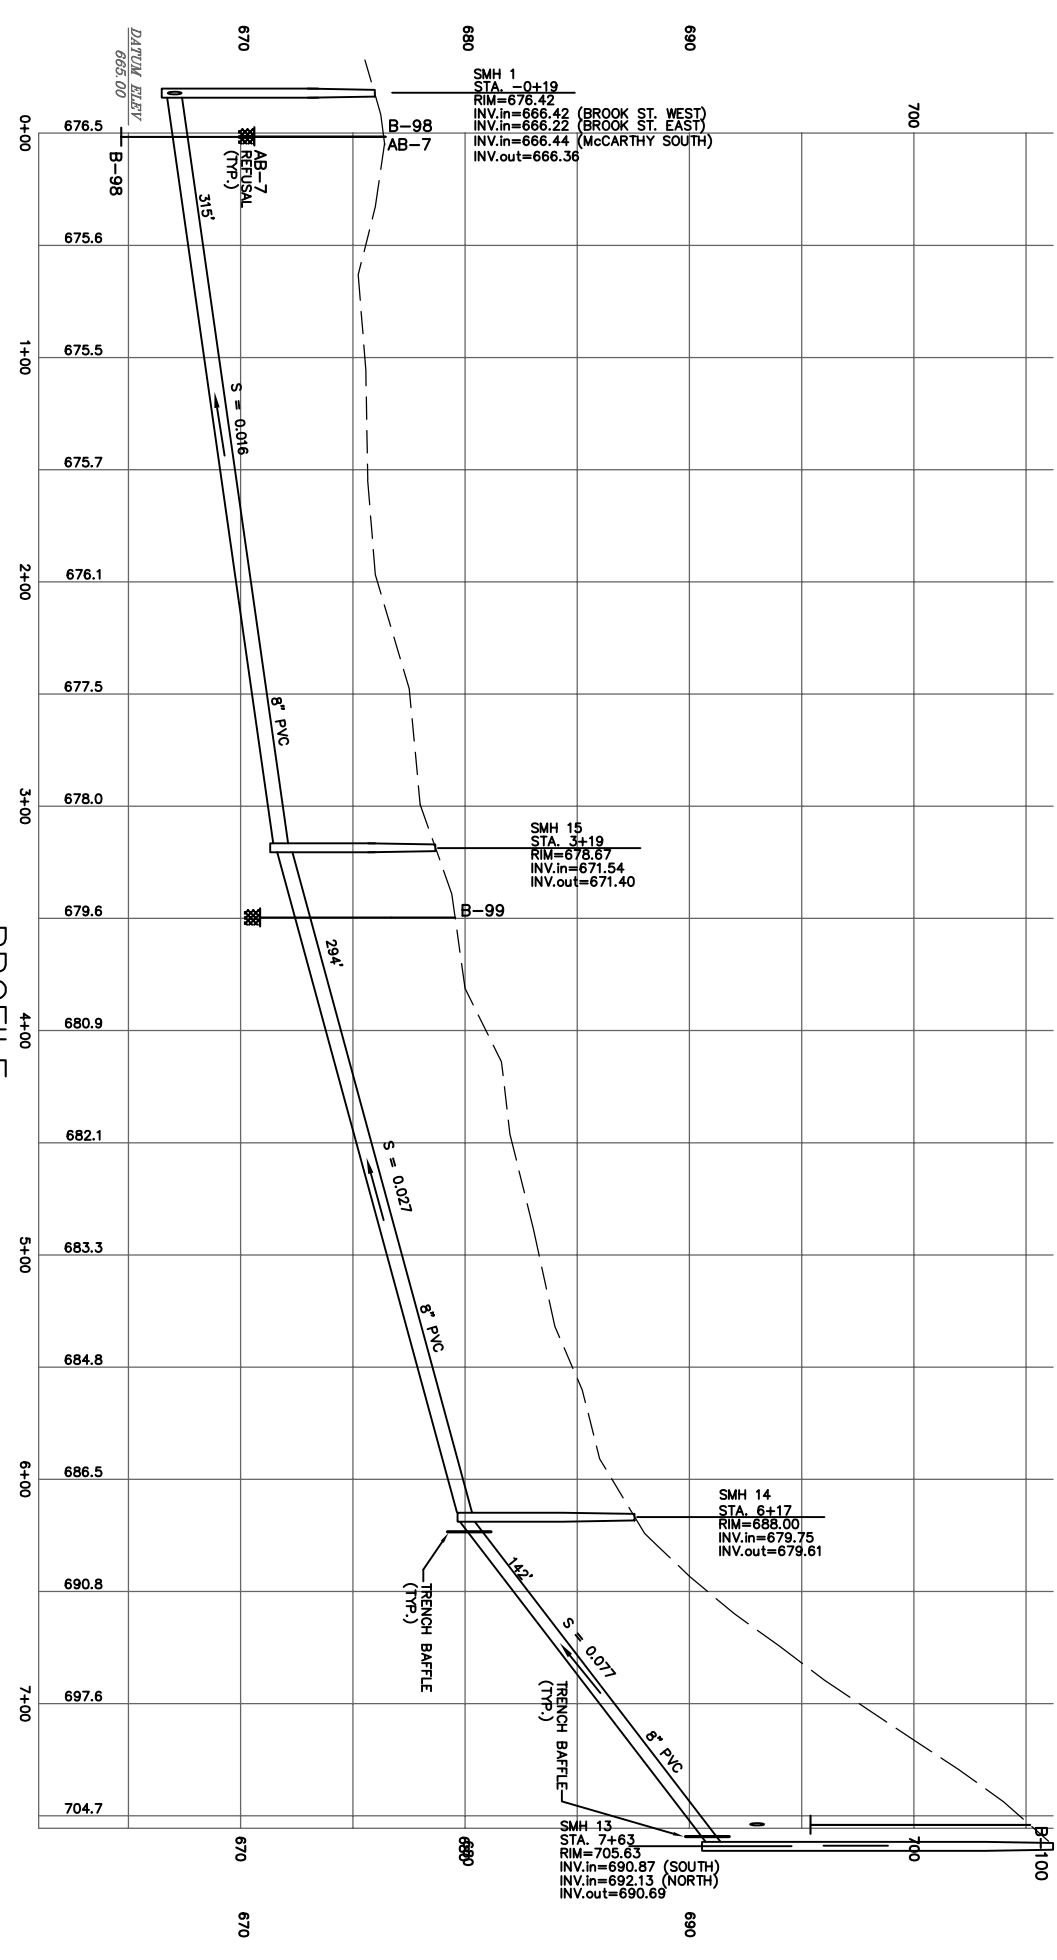

PROFILE
SCALE: 1"=40' HORIZ.
1"=4' VERT.

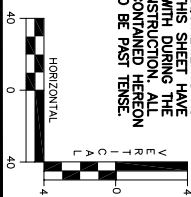

RECORD DRAWING!
I HEREBY CERTIFY THAT TO THE BEST OF MY KNOWLEDGE, BASED UPON CONSTRUCTION RECORDS PROVIDED BY THE RESIDENT ENGINEER AND THE CONSTRUCTION DRAWING HAS BEEN COMPLETED AS SHOWN.
HOYLE, TANNER & ASSOCIATES, INC.

NOTE:
ALL PROJECT REQUIREMENTS AS SET FORTH ON THIS SHEET HAVE BEEN COMPLIED WITH DURING THE COURSE OF CONSTRUCTION. ALL NOTE WORKING CONTAINED HEREON IS UNDERSTOOD TO BE PAST TENSE.

SHEET 6 OF 38	DRAWING NO. 6	CHERRY VALLEY SEWER DISTRICT LEICESTER, MASSACHUSETTS		Hoyle, Tanner & Associates, Inc. 150 Dow Street • Manchester • New Hampshire 03101 Consulting Engineers		PROJECT NO. 105709			ENGINEER/ARCHITECT
		BROOK STREET (WEST) 0+00 TO 7+54		SCALE: AS SHOWN	DATE: APRIL 2001	DES. BY JAH	DR. BY CAB/RCP	CHKD. BY NLT	FILE NAME ABPROF-04 DO NOT SCALE DRAWING
						REV.	DESCRIPTION	C.B. W.C. W.C. 10/02 DR. BY CHKD. BY APPD. BY DATE	