


PLAN  
SCALE: 1"=40'

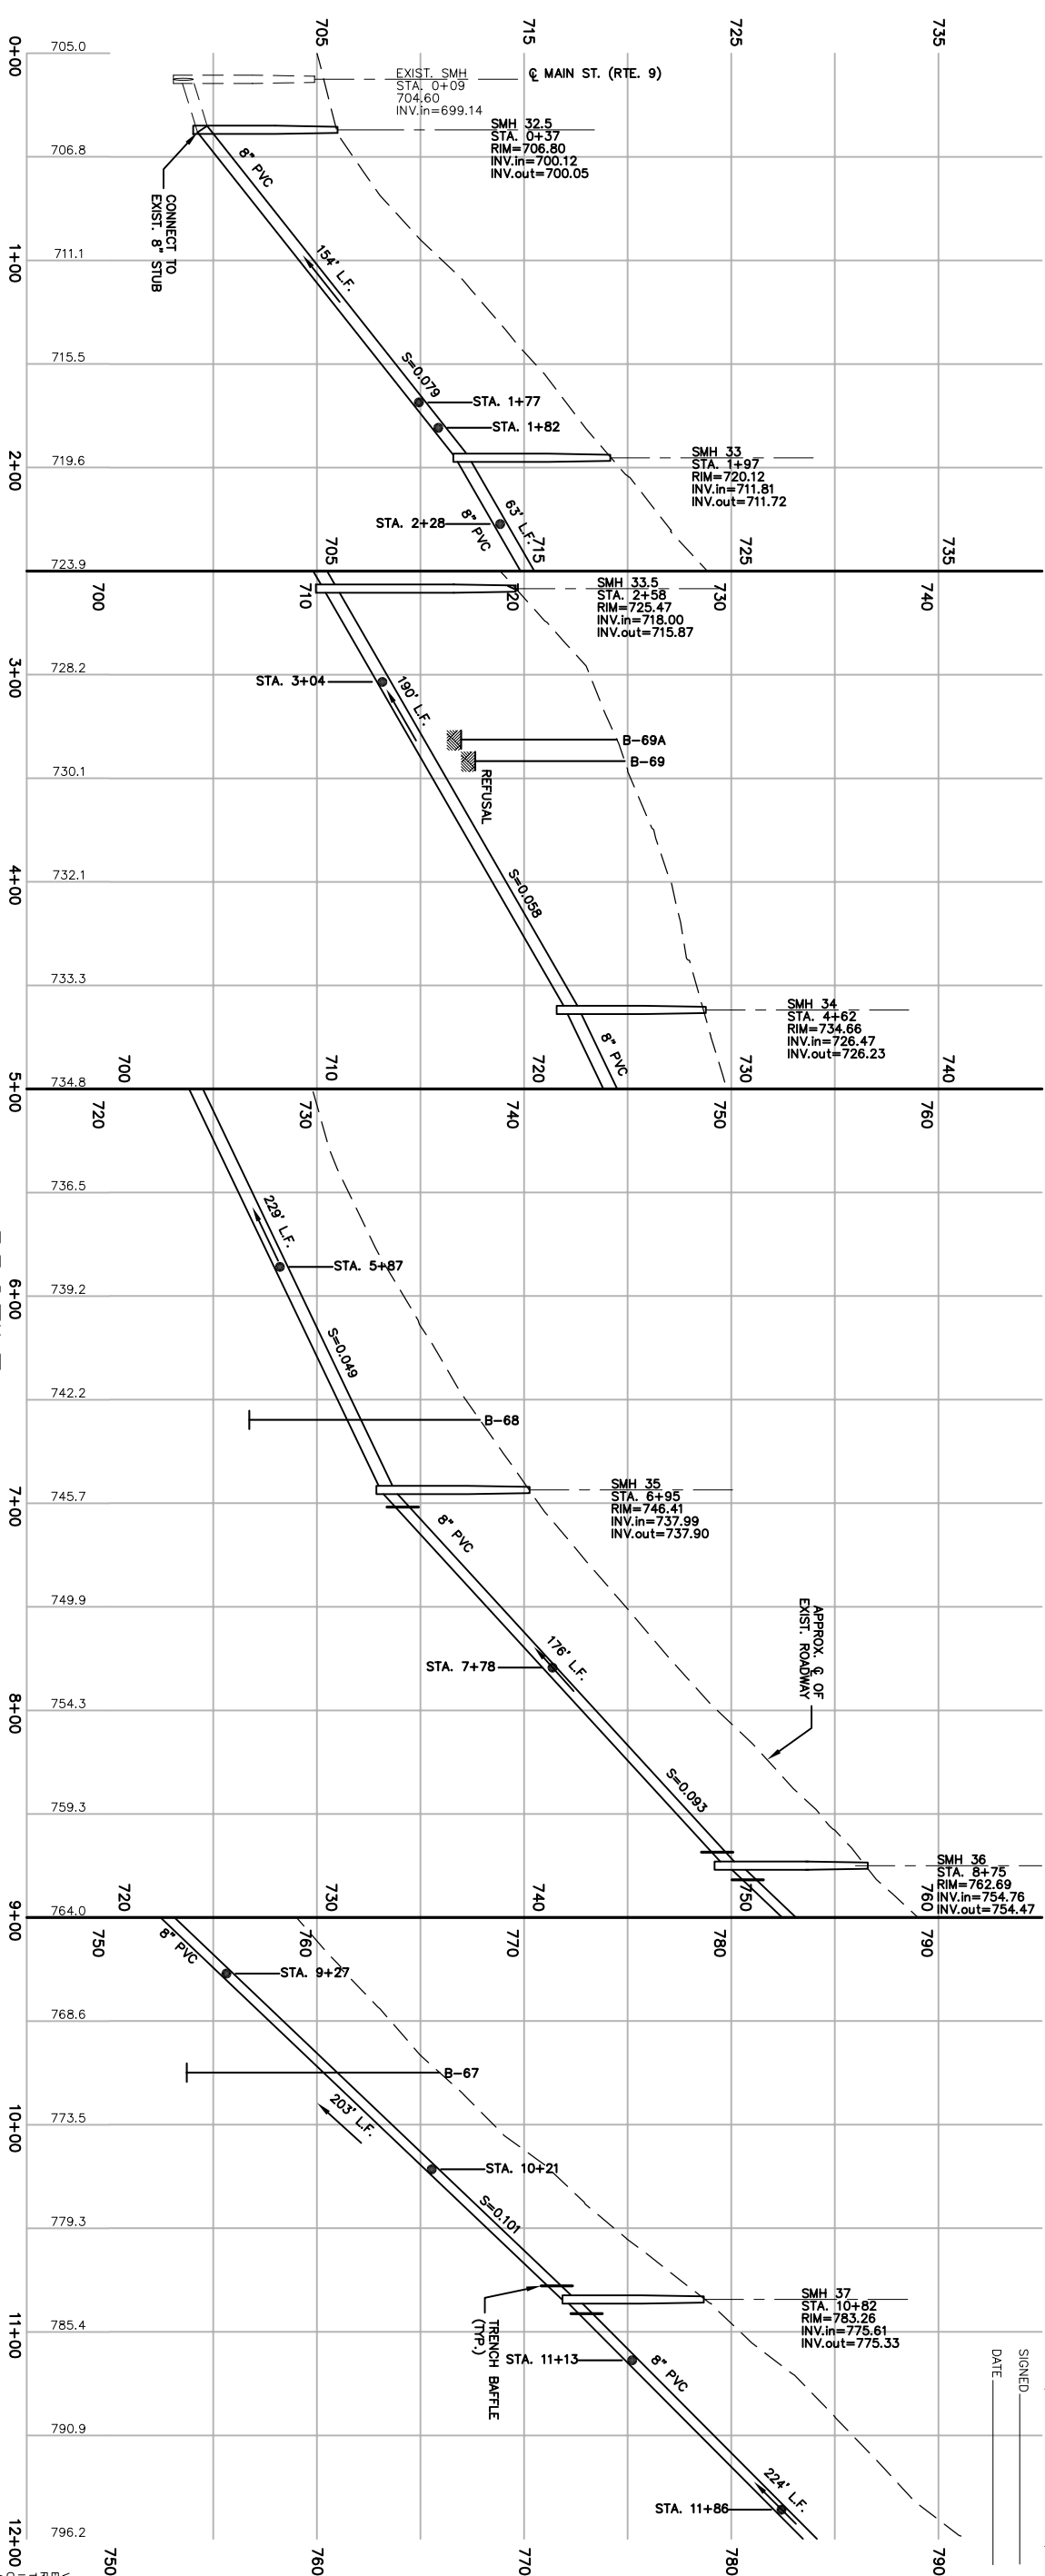


PROFILE  
SCALE: 1"=40' HORZ.  
1"=4' VERT.

**'AS-BUILT'**

I HEREBY CERTIFY THAT TO THE BEST OF MY KNOWLEDGE AND BELIEF, THE INFORMATION AND DATA PROVIDED BY THE RESIDENT ENGINEER AND THE CONTRACTOR, ALL WORK SHOWN ON THIS DRAWING HAS BEEN COMPLETED AS SHOWN.

HOYLE, TANNER & ASSOCIATES, INC.

SIGNED: \_\_\_\_\_  
DATE: \_\_\_\_\_

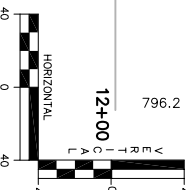

9  
DRAWING NO.  
SHEET 9 OF 18

CHERRY VALLEY SEWER DISTRICT  
LEICESTER, MASSACHUSETTS  
PLAN AND PROFILE  
**BROWN STREET**  
0+00 TO 12+00

**HTA** Hoyle, Tanner & Associates, Inc.  
150 Dow Street • Manchester • New Hampshire 03101  
Consulting Engineers

SCALE: AS SHOWN    DATE: APRIL 2000    DES. BY JAH    DR. BY RCP    CHKD. BY NLT

PROJECT NO.  
105707  
FILE NAME  
AB105P08

DO NOT SCALE DRAWING

REV.	DESCRIPTION	DR. BY	CHKD. BY	APPD. BY	DATE
1.	AS-BUILTS	C.B.	J.H.	J.H.	12/00

ENGINEER/ARCHITECT