


MATCH LINE SEE SHEET 34 OF 38


ENGINEER/ARCHITECT

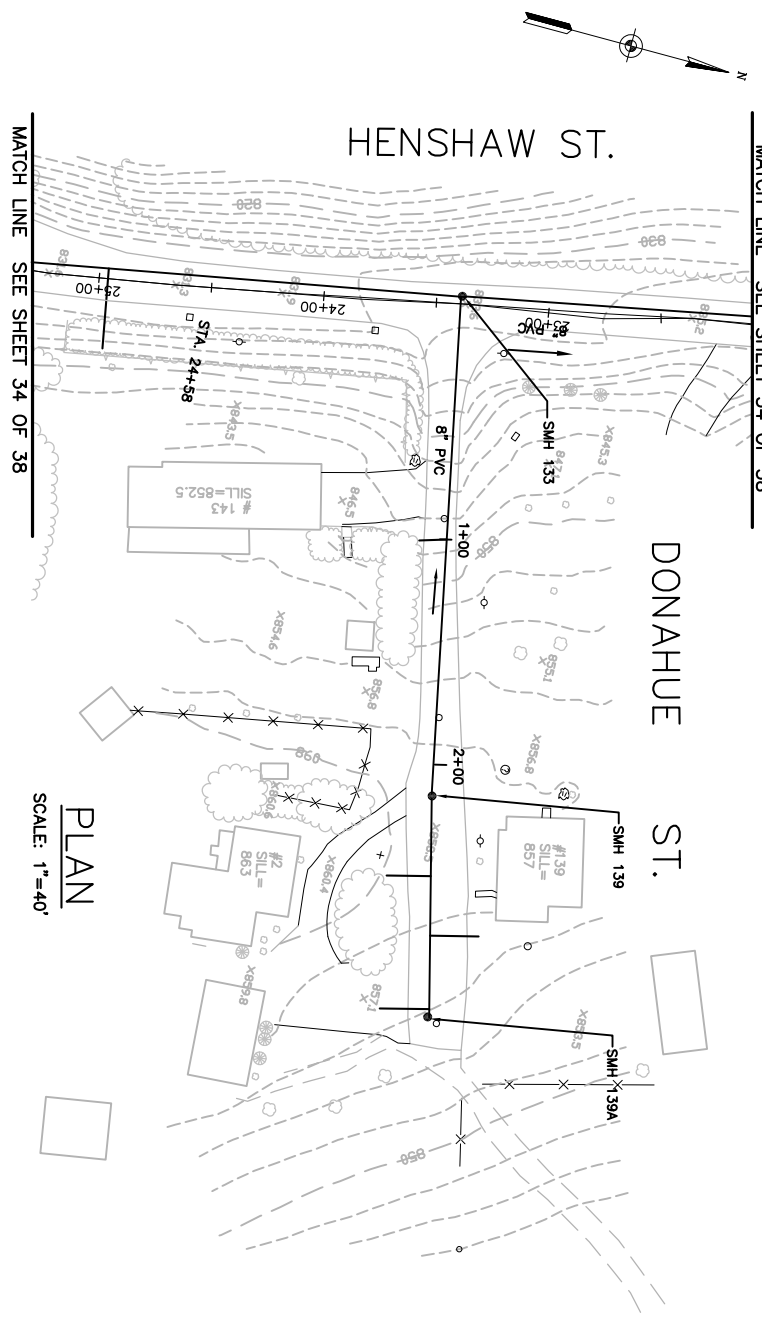

PLAN

SCALE: 1"=40'

MATCH LINE SEE SHEET 34 OF 38

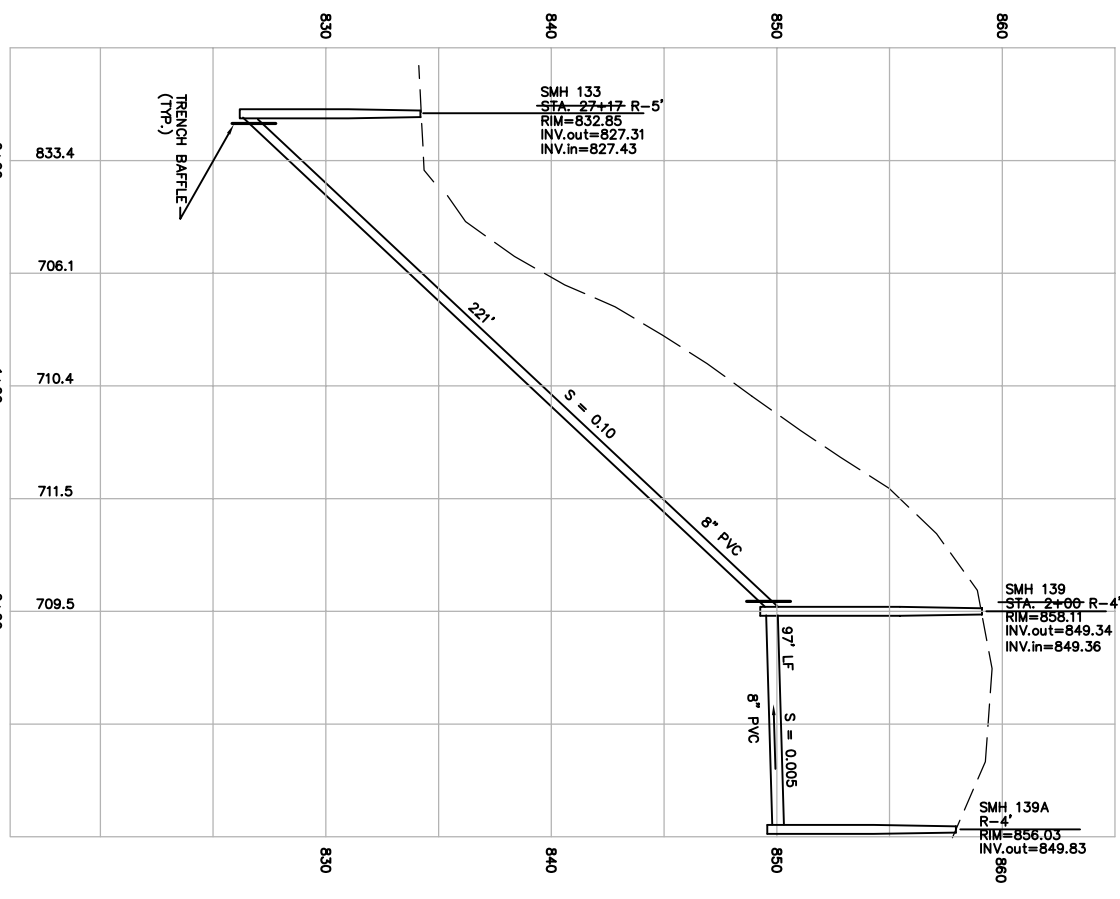

PROFILE

SCALE: 1"=40' HORIZ.
1"=4' VERT.

DATE: 08/00


RECORD DRAWING

I HEREBY CERTIFY THAT TO THE BEST OF MY KNOWLEDGE, BASED UPON CONSTRUCTION RECORDS PROVIDED BY THE RESIDENT ENGINEER AND THE CONTRACTOR, THE DRAWING HAS BEEN COMPLETED AS SHOWN.

HOYLE, TANNER & ASSOCIATES, INC.

NOTE:

ALL PROJECT REQUIREMENTS AS SET FORTH ON THIS SHEET HAVE BEEN COMPLETED WITH DURING THE COURSE OF CONSTRUCTION. ALL NOTE WORDING CONTAINED HEREON IS UNDERSTOOD TO BE PAST TENSE.

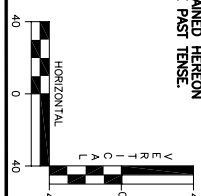

DRAWING NO. 35	CHERRY VALLEY SEWER DISTRICT LEICESTER, MASSACHUSETTS
	GERTRUDE AVE. / DONAHUE ST.

HTA Hoyle, Tanner & Associates, Inc.
150 Dow Street • Manchester • New Hampshire 03101
Consulting Engineers

SCALE: AS SHOWN	DATE: APRIL 2001	DES. BY JAH	DR. BY CAB/RCP	CHKD. BY NLT
-----------------	------------------	----------------	-------------------	-----------------

PROJECT NO. 105709	FILE NAME ABPROF-35	DO NOT SCALE DRAWING
1. RECORD DRAWING	C.B. W.C. W.C. 10/02	DR. CHKD. APPD. DATE

SHEET 35 OF 38