



HENSHAW STREET

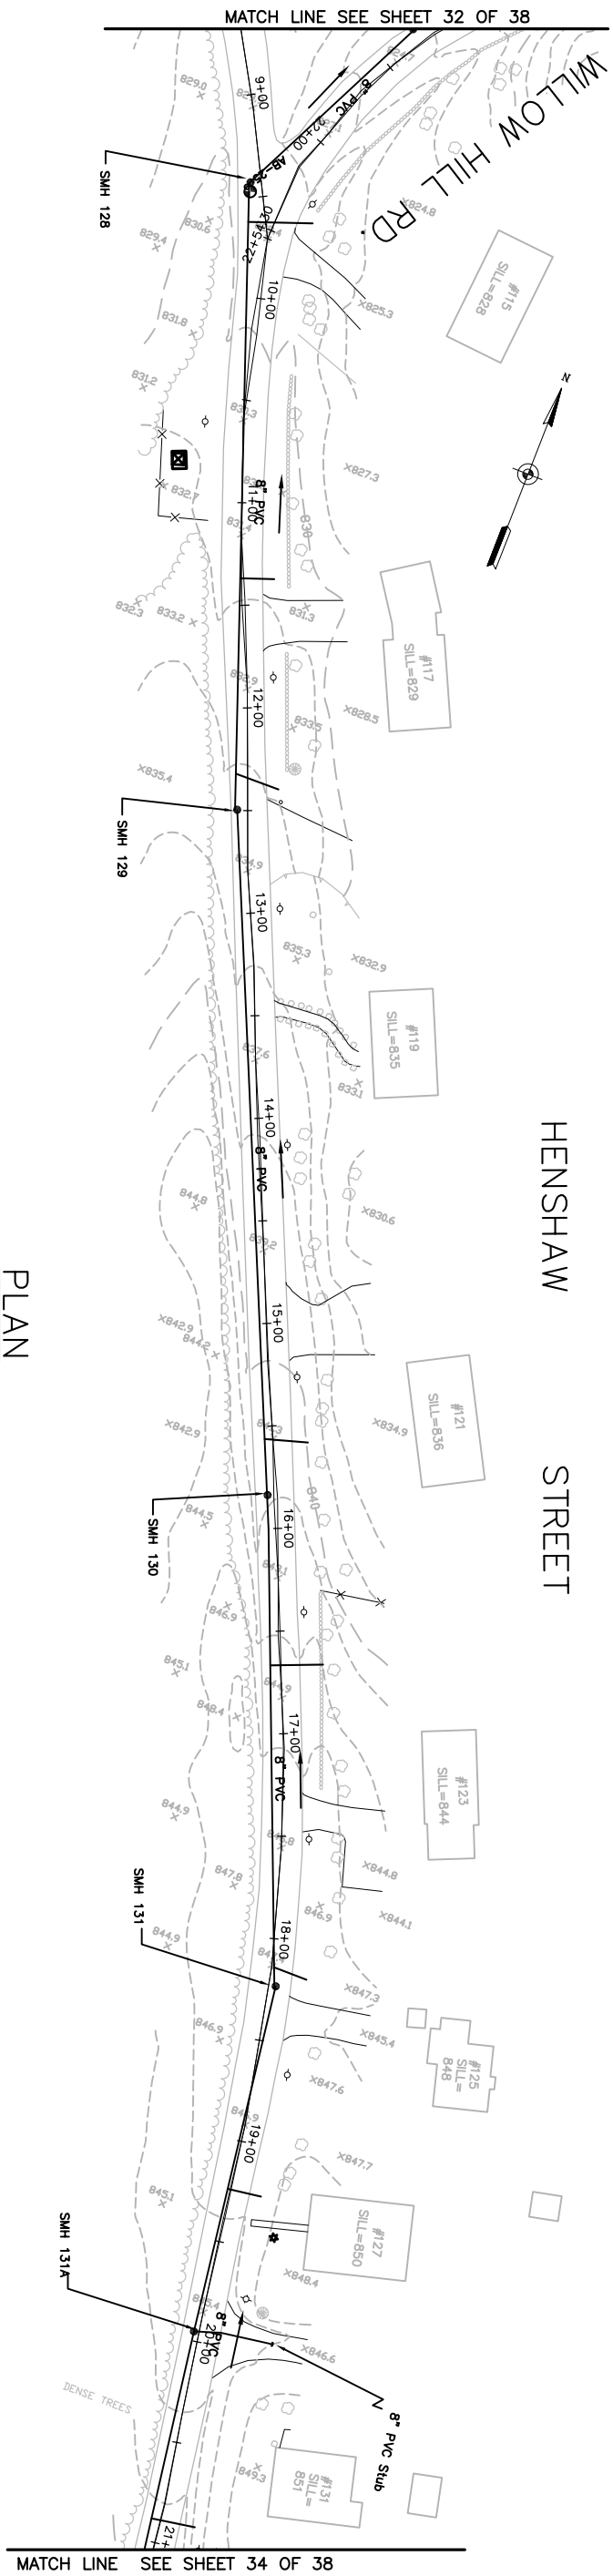

PLAN  
SCALE: 1"=40'

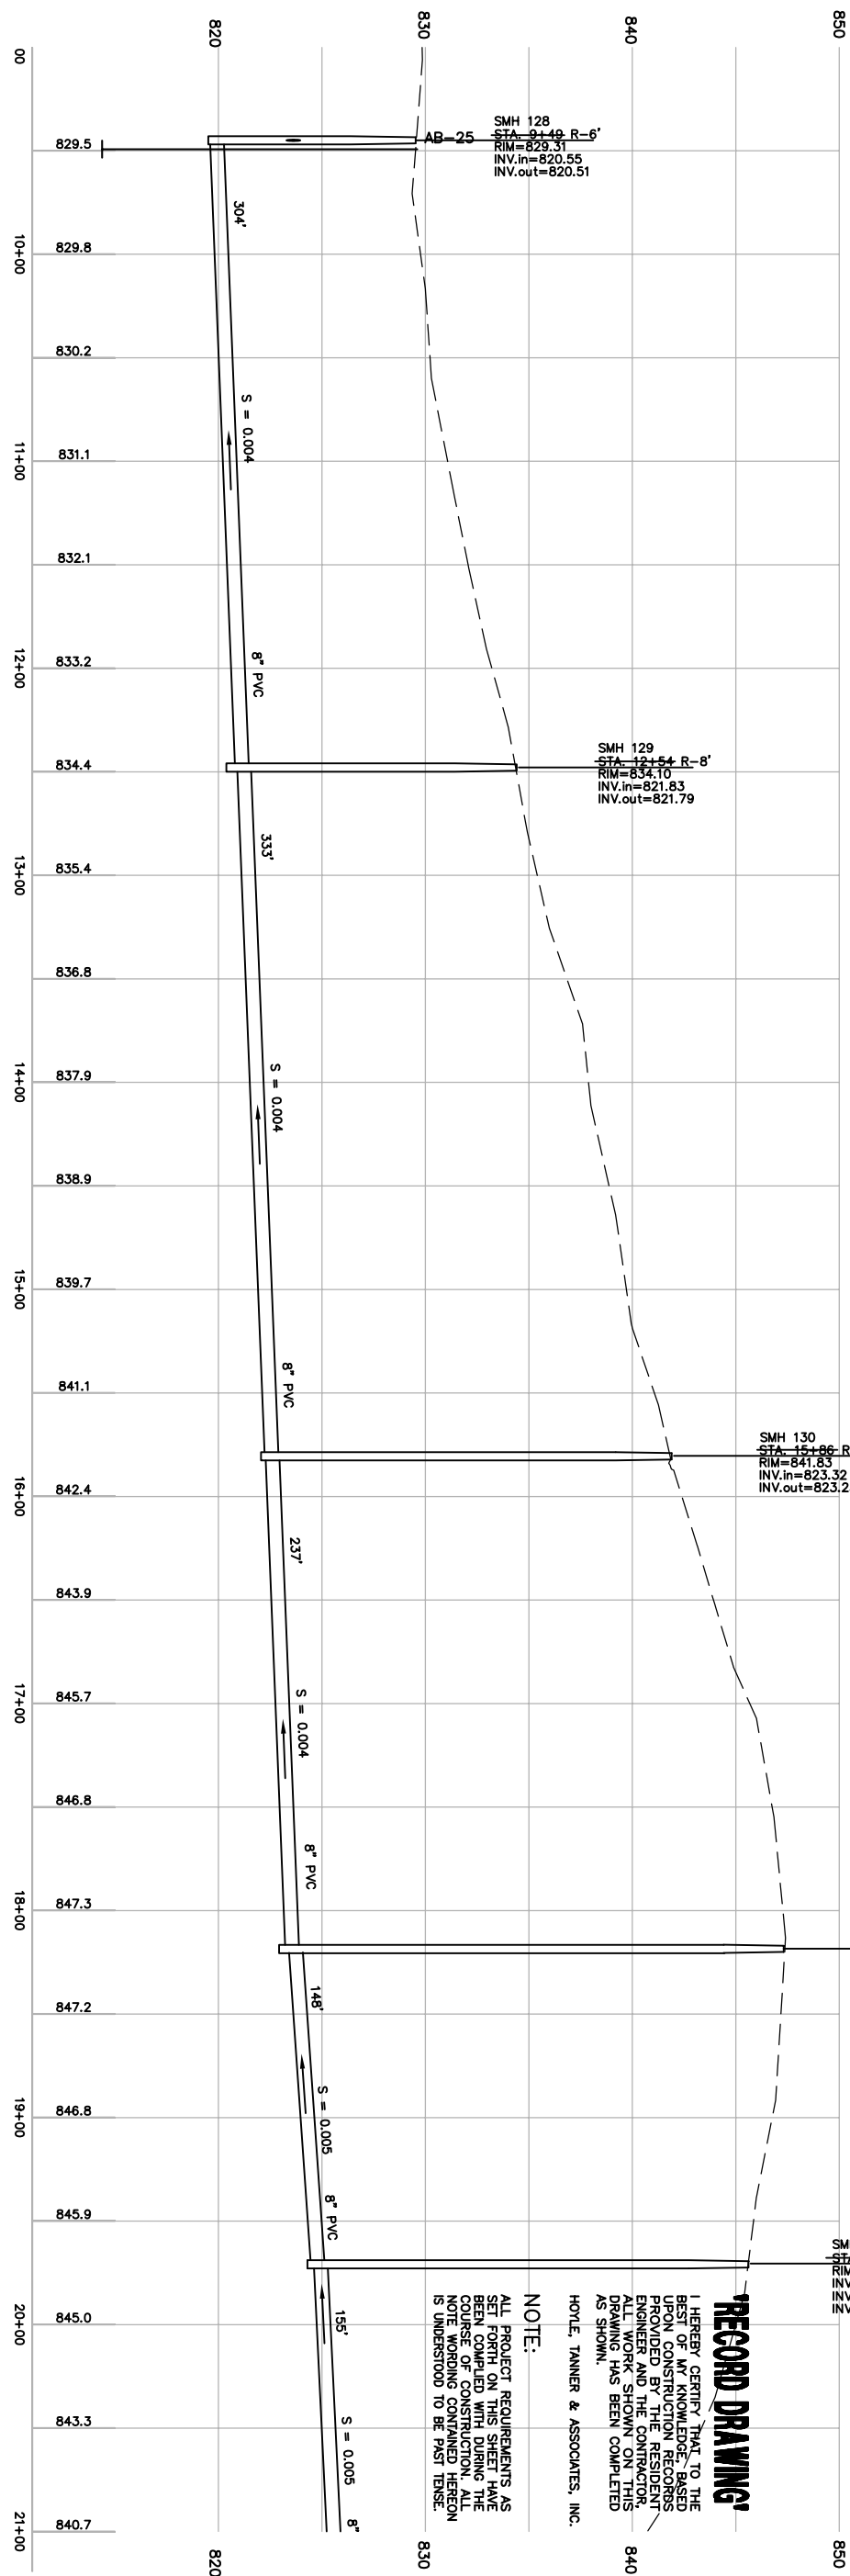

**'RECORD DRAWING'**


I HEREBY CERTIFY THAT TO THE BEST OF MY KNOWLEDGE, BASED UPON CONSTRUCTION RECORDS PROVIDED BY THE RESIDENT, ENGINEER AND THE CONTRACTOR, ALL WORK SHOWN ON THIS DRAWING HAS BEEN COMPLETED AS SHOWN.

HOYLE, TANNER & ASSOCIATES, INC.

**NOTE:**

ALL PROJECT REQUIREMENTS AS SET FORTH IN THE SPECIFICATIONS HAVE BEEN COMPLIED WITH DURING THE COURSE OF CONSTRUCTION. ALL NOTE WORDING CONTAINED HEREON IS UNDERSTOOD TO BE PAST TENSE.

PROFILE  
SCALE: 1"=40' HORIZ.  
1"=4' VERT.

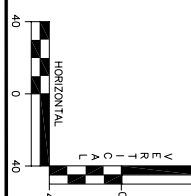

CHERRY VALLEY SEWER DISTRICT LEICESTER, MASSACHUSETTS PLAN AND PROFILE <b>HENSHAW STREET</b>		<b>HTA</b> Hoyle, Tanner & Associates, Inc. 150 Dow Street • Manchester • New Hampshire 03101 Consulting Engineers		PROJECT NO. 105709		FILE NAME ABPROF-33		C.B. W.C. W.C. 10/02	
DRAWING NO. <b>33</b>		SCALE: AS SHOWN		DATE: APRIL 2001		DES. BY JAH		DR. BY CAB/RCP	
SHEET <b>33</b> OF 38		CHKD. BY NLT		DO NOT SCALE DRAWING		1. RECORD DRAWING		DR. BY W.C.	

ENGINEER/ARCHITECT