


PLAN  
SCALE: 1"=40'

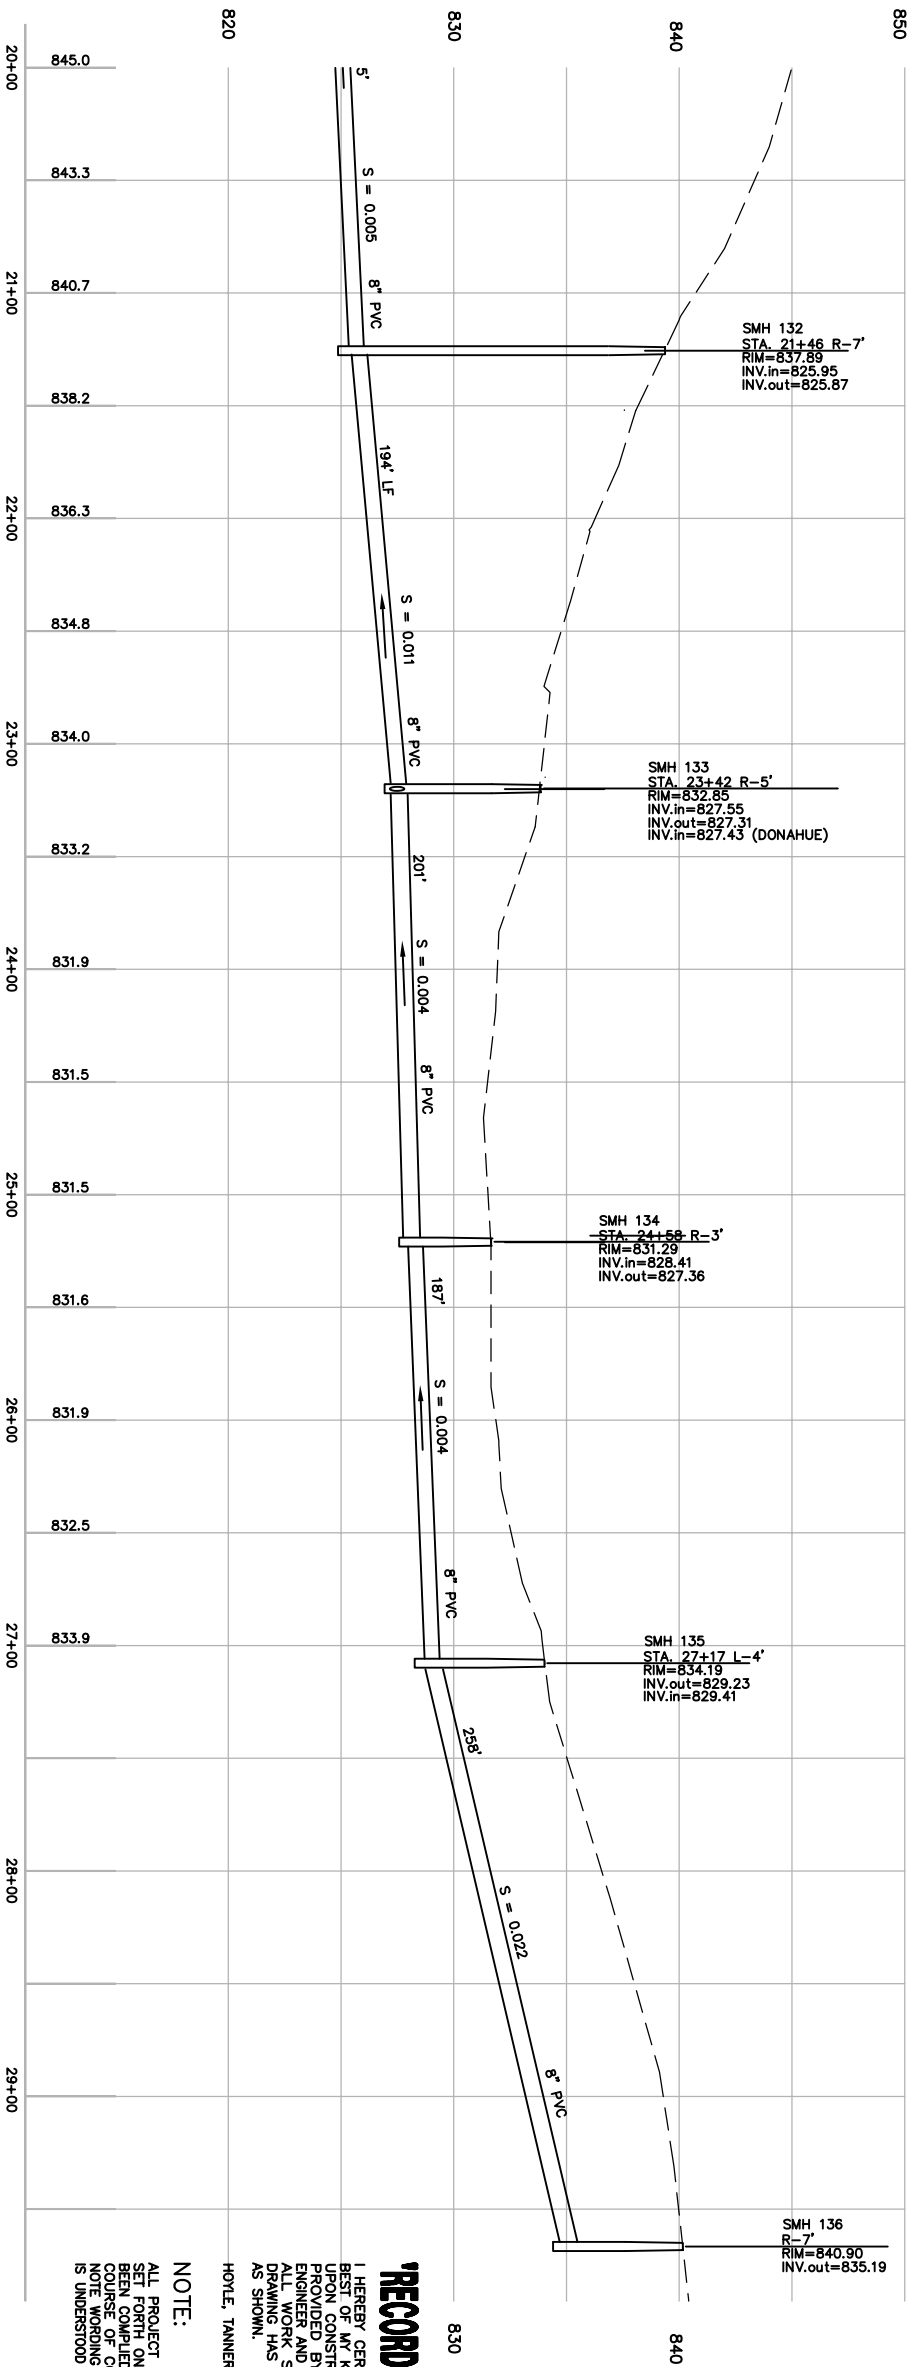


PROFILE  
SCALE: 1"=40' HORIZ.  
1"=4' VERT.

**RECORD DRAWING**

I HEREBY CERTIFY THAT TO THE BEST OF MY KNOWLEDGE, BASED UPON CONSTRUCTION RECORDS PROVIDED BY THE CONTRACTOR, ALL WORK SHOWN ON THIS DRAWING HAS BEEN COMPLETED AS SHOWN.

HOYLE, TANNER & ASSOCIATES, INC.

NOTE:  
ALL PROJECT REQUIREMENTS AS SET FORTH ON THIS SHEET HAVE BEEN COMPLETED WITH DURING THE COURSE OF CONSTRUCTION. ALL NOTE WORDING CONTAINED HEREON IS UNDERSTOOD TO BE PAST TENSE.

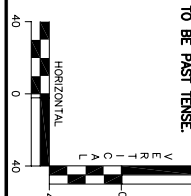

DRAWING NO. <b>34</b>	CHERRY VALLEY SEWER DISTRICT LEICESTER, MASSACHUSETTS		<b>Hoyle, Tanner &amp; Associates, Inc.</b> 150 Dow Street • Manchester • New Hampshire 03101 Consulting Engineers			PROJECT NO. 105709					ENGINEER/ARCHITECT
	HENSHAW STREET		SCALE: AS SHOWN	DATE: APRIL 2001	DES. BY JAH	DR. BY CAB/RCP	CHKD. BY NLT	FILE NAME ABPROF-34	DO NOT SCALE DRAWING	1. RECORD DRAWING	
SHEET 34 OF 38											