



MICHAEL AVENUE

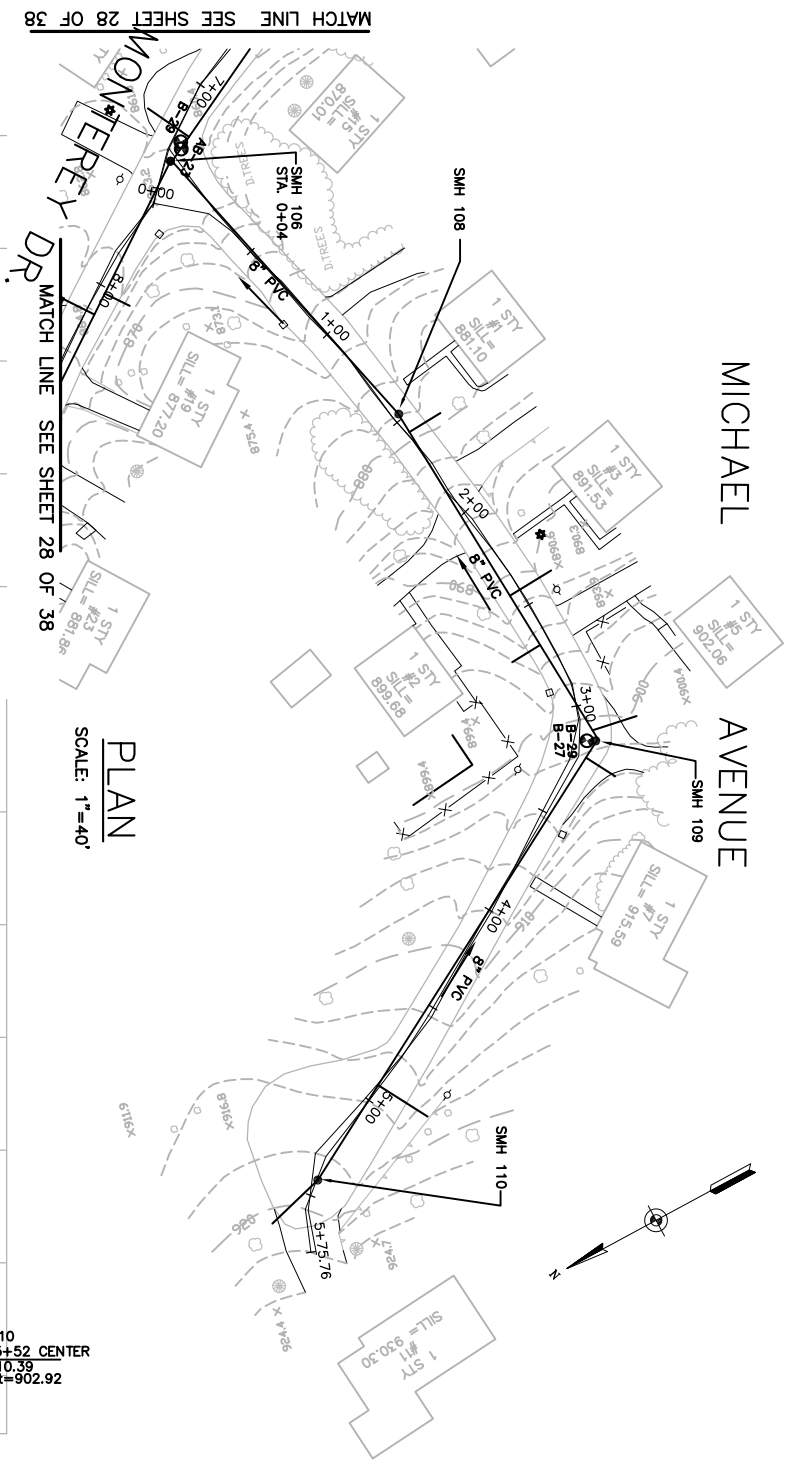


PLAN
SCALE: 1"=40'

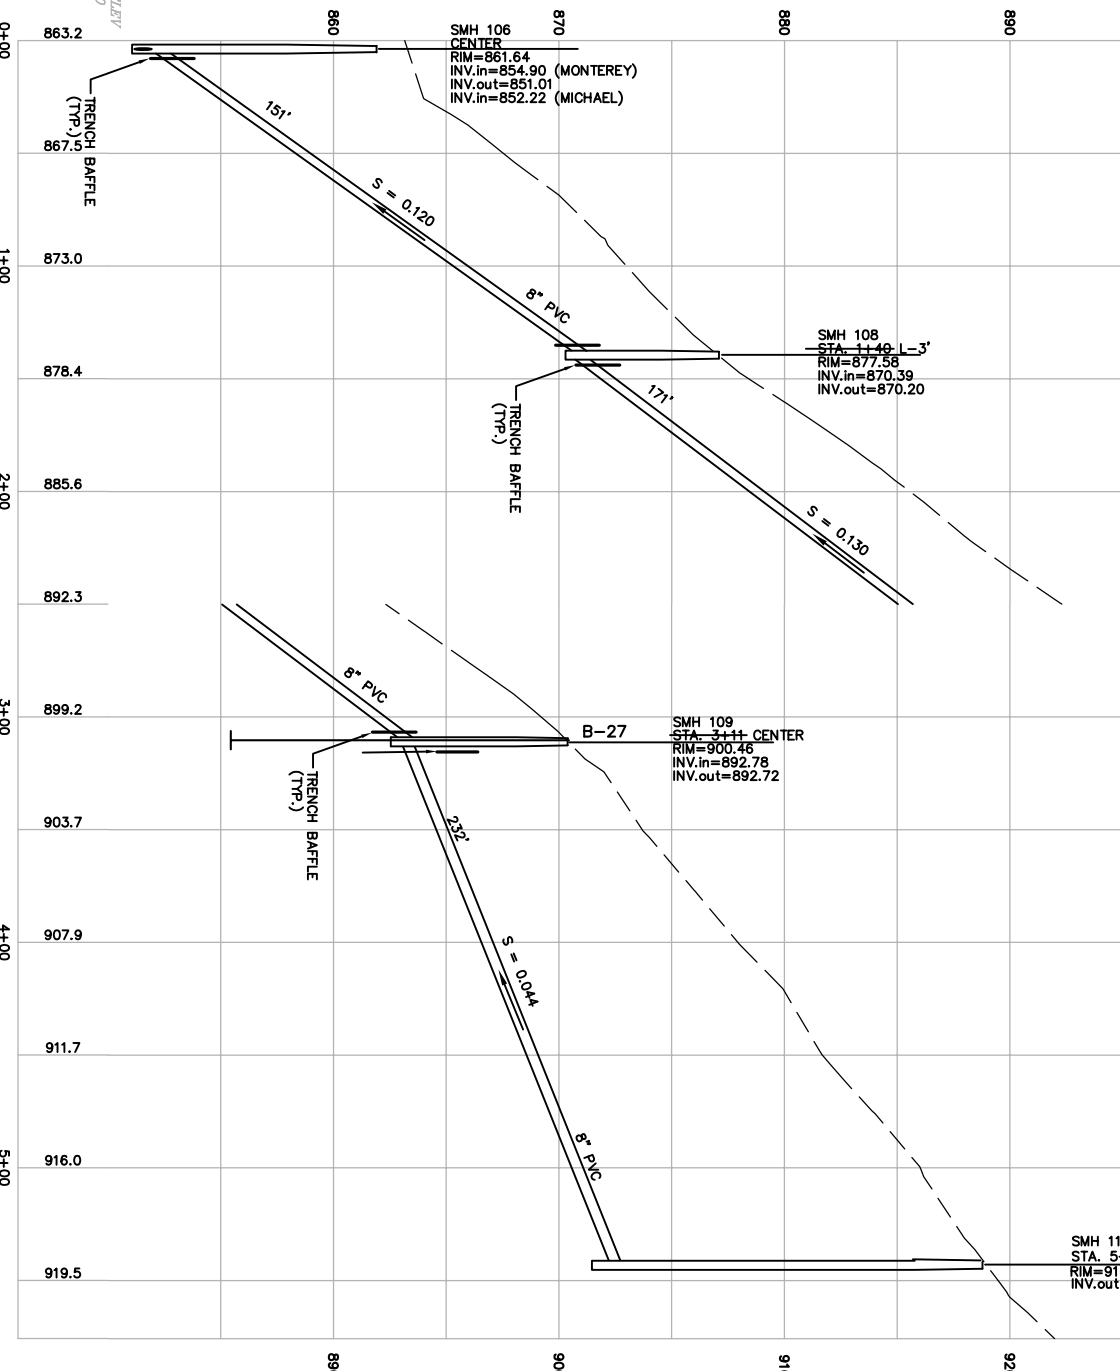


PROFILE
SCALE: 1"=40' HORIZ.
1"=4' VERT.

COLONIAL DRIVE

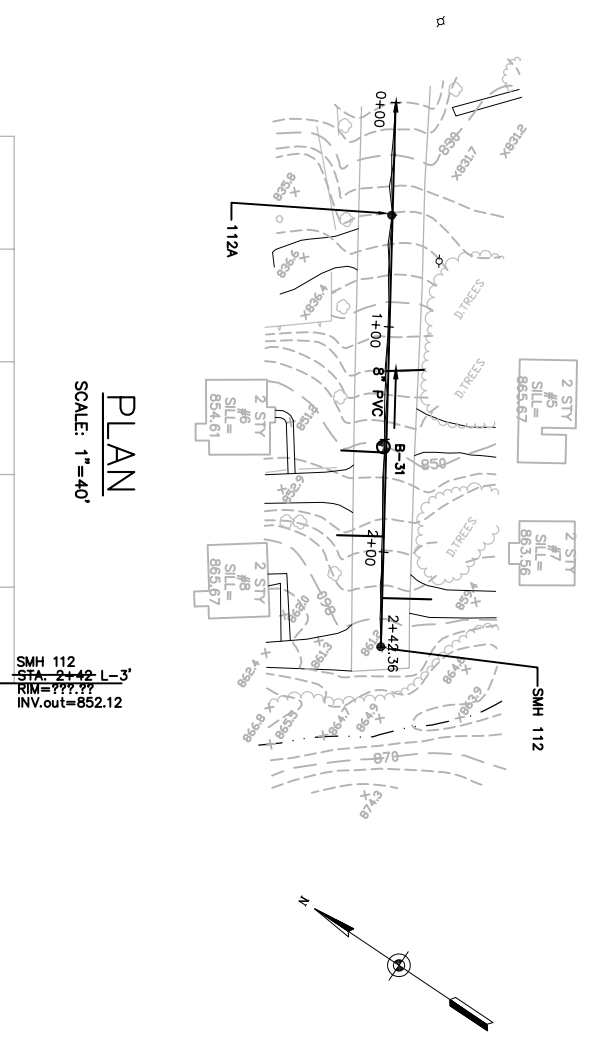

PLAN
SCALE: 1"=40'

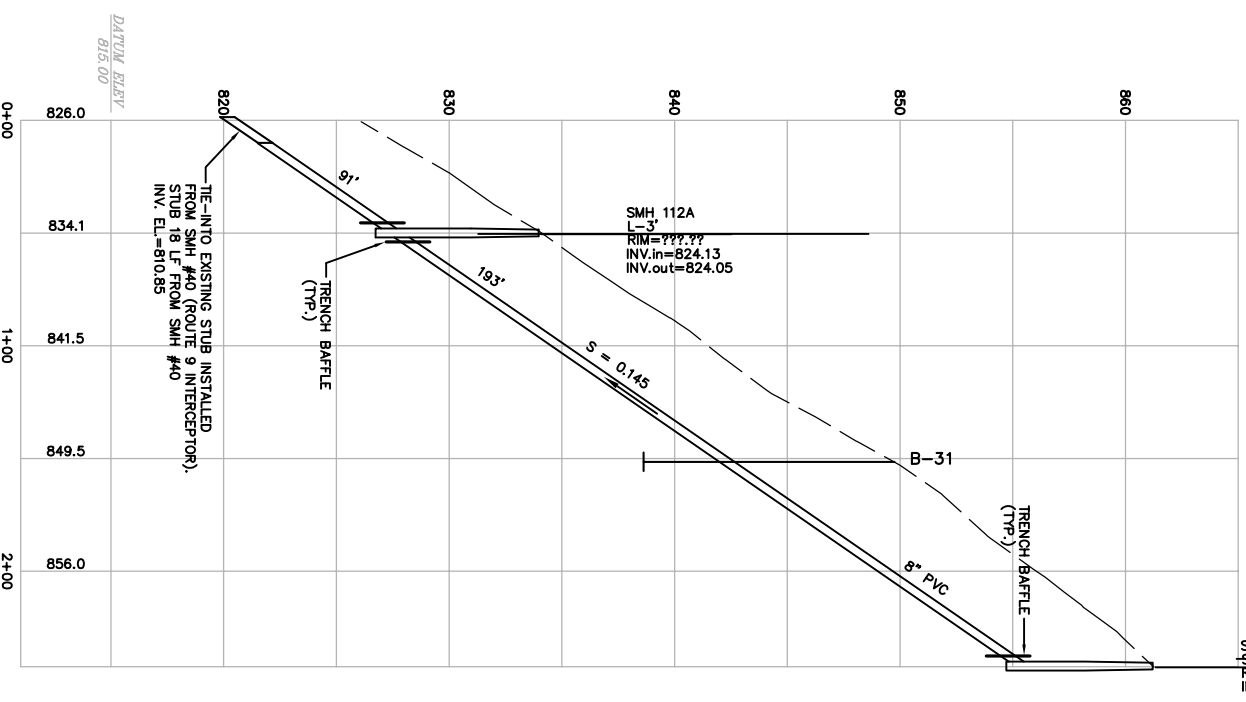


PROFILE
SCALE: 1"=40' HORIZ.
1"=4' VERT.

RECORD DRAWING

I HEREBY CERTIFY THAT TO THE BEST OF MY KNOWLEDGE, BASED UPON CONSTRUCTION RECORDS PROVIDED BY THE RESIDENT, ENGINEER AND THE CONTRACTOR, ALL WORK SHOWN ON THIS DRAWING HAS BEEN COMPLETED AS SHOWN.
HOYLE, TANNER & ASSOCIATES, INC.

NOTE:

ALL PROJECT REQUIREMENTS AS SET FORTH ON THIS SHEET HAVE BEEN CONSIDERED AND THE COURSE OF CONSTRUCTION AT THE NOTE WORKING CONTAINED HEREON IS UNDERSTOOD TO BE PAST TENSE.

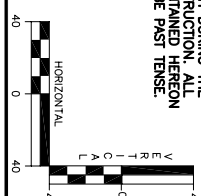

DRAWING NO. 29	CHERRY VALLEY SEWER DISTRICT LEICESTER, MASSACHUSETTS	Hoyle, Tanner & Associates, Inc. 150 Dow Street • Manchester • New Hampshire 03101 Consulting Engineers	PROJECT NO. 105709	ENGINEER/ARCHITECT			
	MICHAEL AVE. / COLONIAL DR. STA. 0+00 TO 12+00		FILE NAME ABPROF-28	1. RECORD DRAWING	C.B.	W.C.	W.C.
SHEET 29 OF 38		SCALE: AS SHOWN	DATE: APRIL 2001	DES. BY JAH	DR. BY CAB/RCP	CHKD. BY NLT	DO NOT SCALE DRAWING