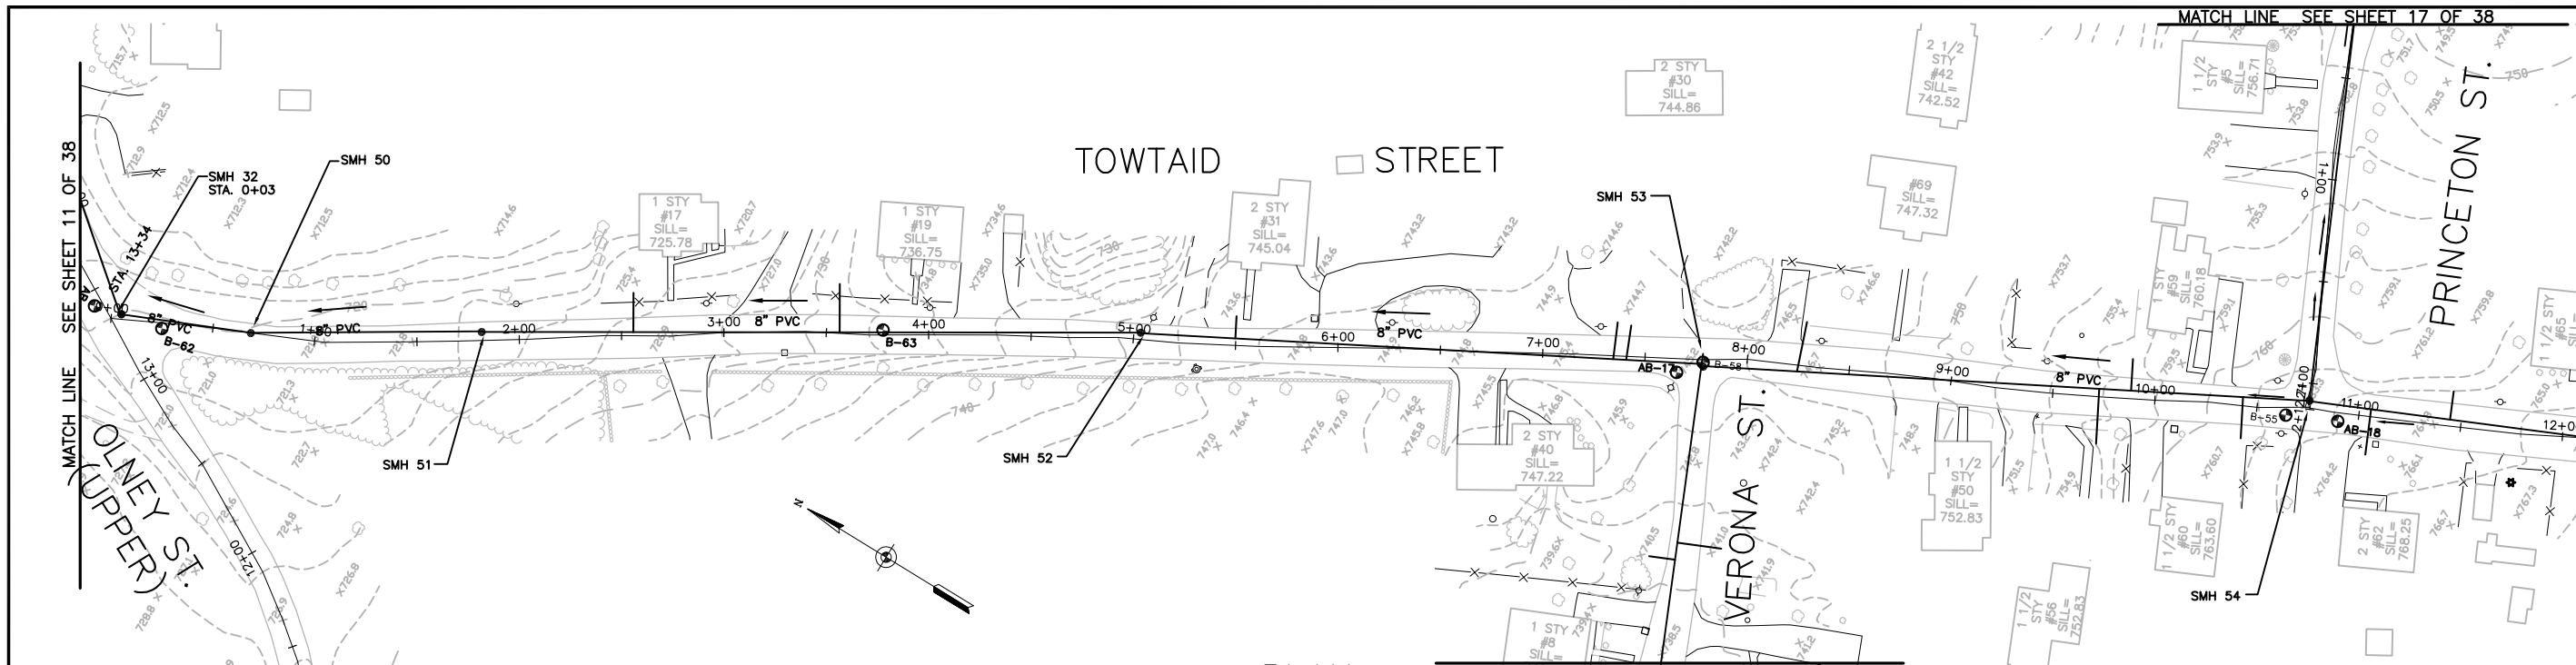

PLAN

SCALE: 1"=40'

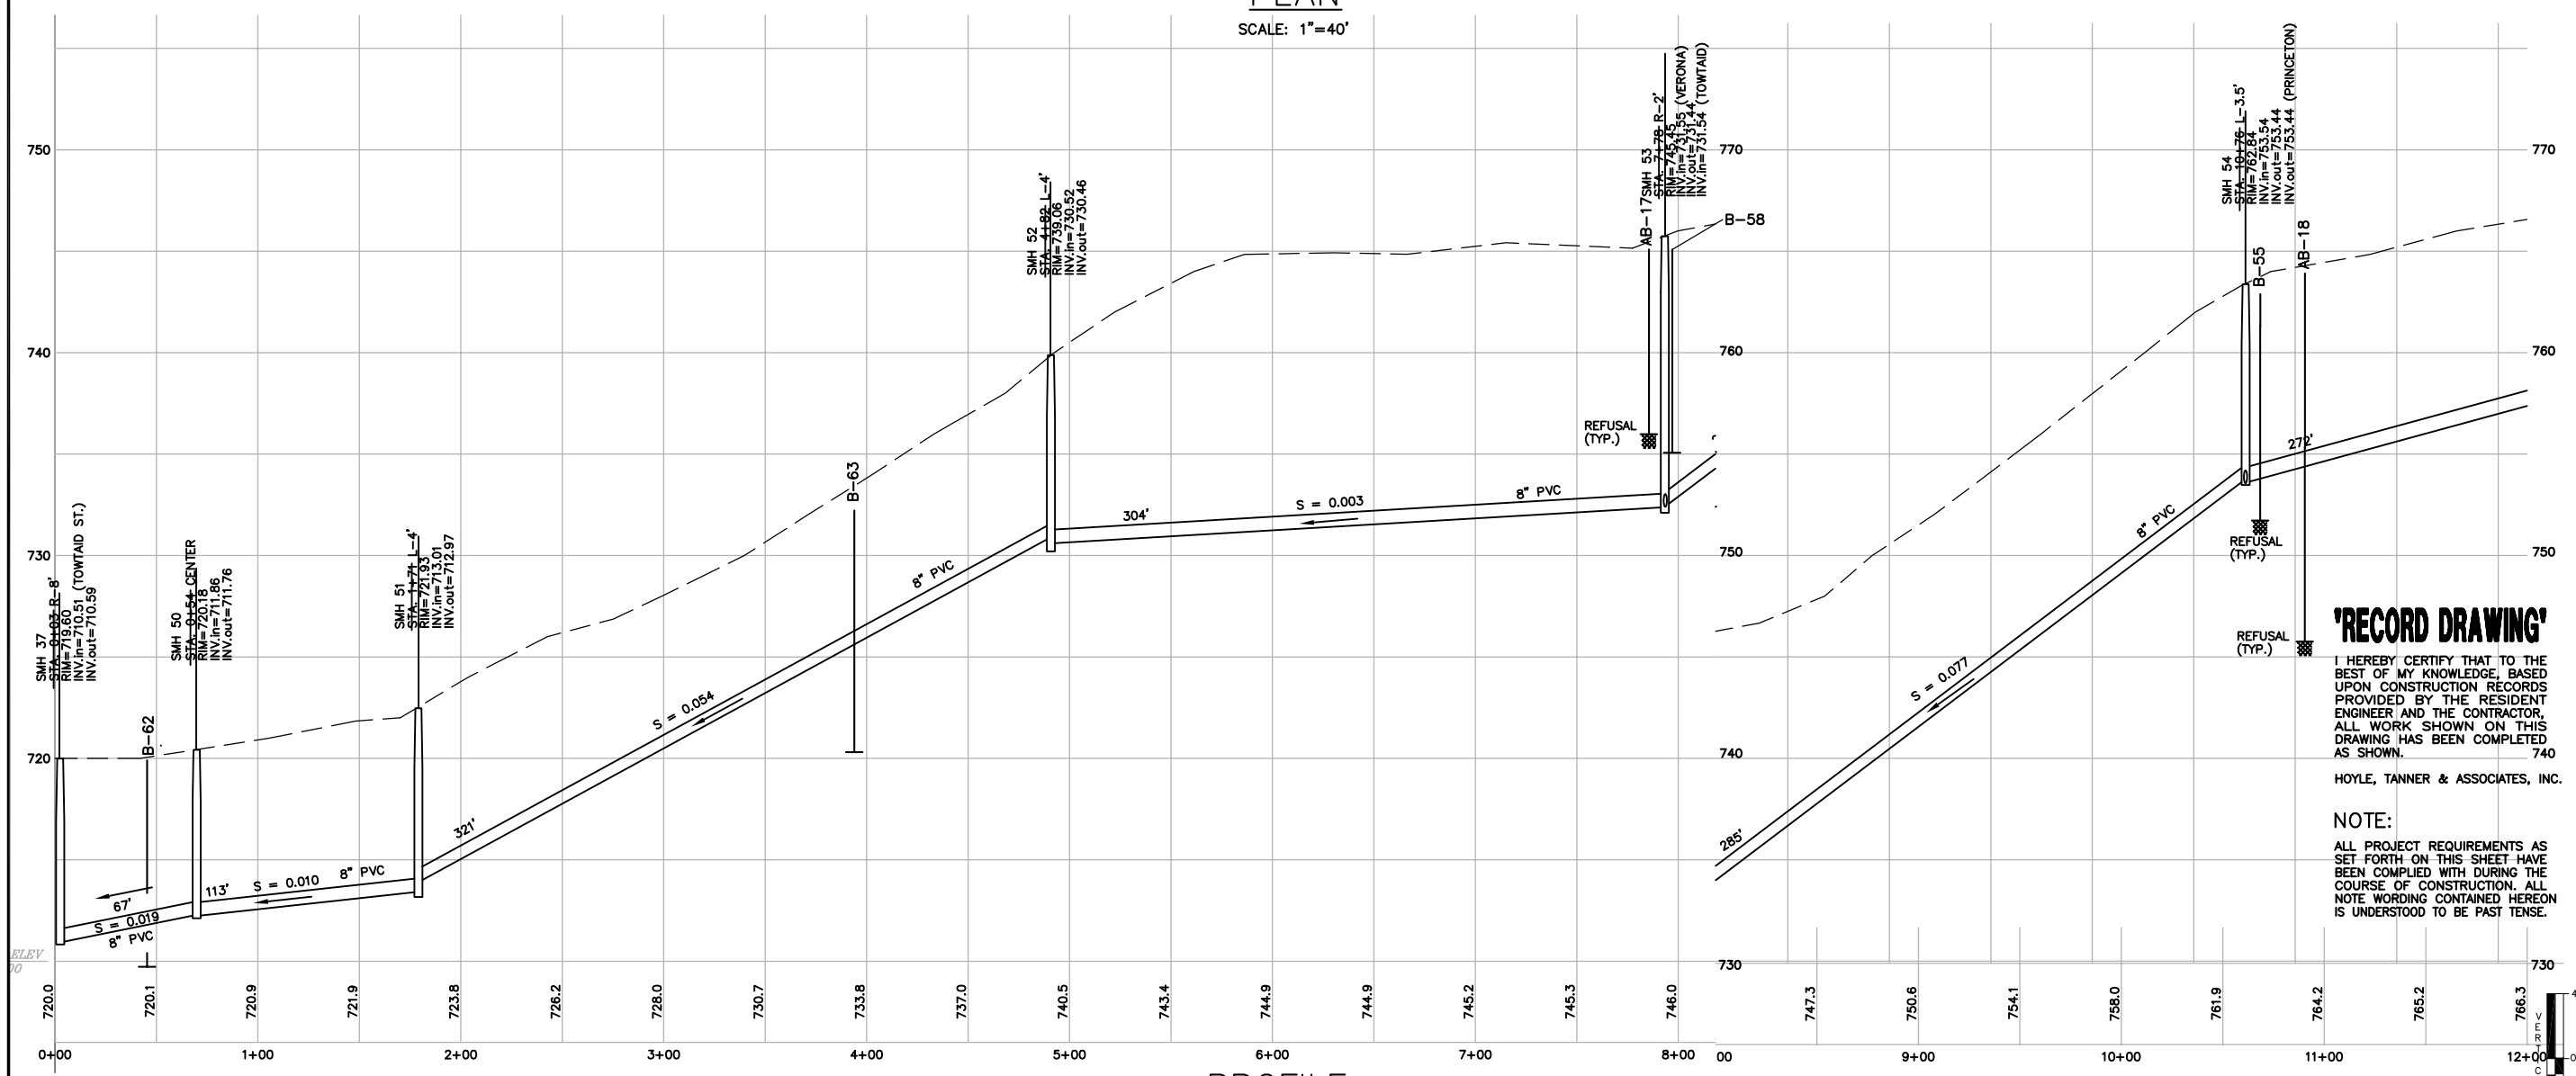

PROFILE

SCALE: 1"=40' HORZ.
1"=4' VERT.

'RECORD DRAWING'

I HEREBY CERTIFY THAT TO THE BEST OF MY KNOWLEDGE, BASED UPON CONSTRUCTION RECORDS PROVIDED BY THE RESIDENT ENGINEER AND THE CONTRACTOR, ALL WORK SHOWN ON THIS DRAWING HAS BEEN COMPLETED AS SHOWN.

HOYLE, TANNER & ASSOCIATES, INC.

NOTE:

ALL PROJECT REQUIREMENTS AS SET FORTH ON THIS SHEET HAVE BEEN COMPLIED WITH DURING THE COURSE OF CONSTRUCTION. ALL NOTE WORDING CONTAINED HEREON IS UNDERSTOOD TO BE PAST TENSE.

ENGINEER/ARCHITECT

REV.	DESCRIPTION	DR. BY	CHKD. BY	APPD. BY	DATE
1.	RECORD DRAWING	C.B.	W.C.	W.C.	10/02

PROJECT NO. 105709

FILE NAME ABPROF-14

DO NOT SCALE DRAWING

Hoyle, Tanner & Associates, Inc.
Consulting Engineers
150 Dow Street • Manchester • New Hampshire 03101

DES. BY	DR. BY	CHKD. BY
JAH	CAB/RCP	NLT

SCALE: AS SHOWN

DATE: APRIL 2001

CHERRY VALLEY SEWER DISTRICT
LEICESTER, MASSACHUSETTS

PLAN AND PROFILE

TOWTAID STREET
STA. 0+00 TO 12+00

DRAWING NO. 15

SHEET 15 OF 38