


## PLAN

SCALE: 1"=40'

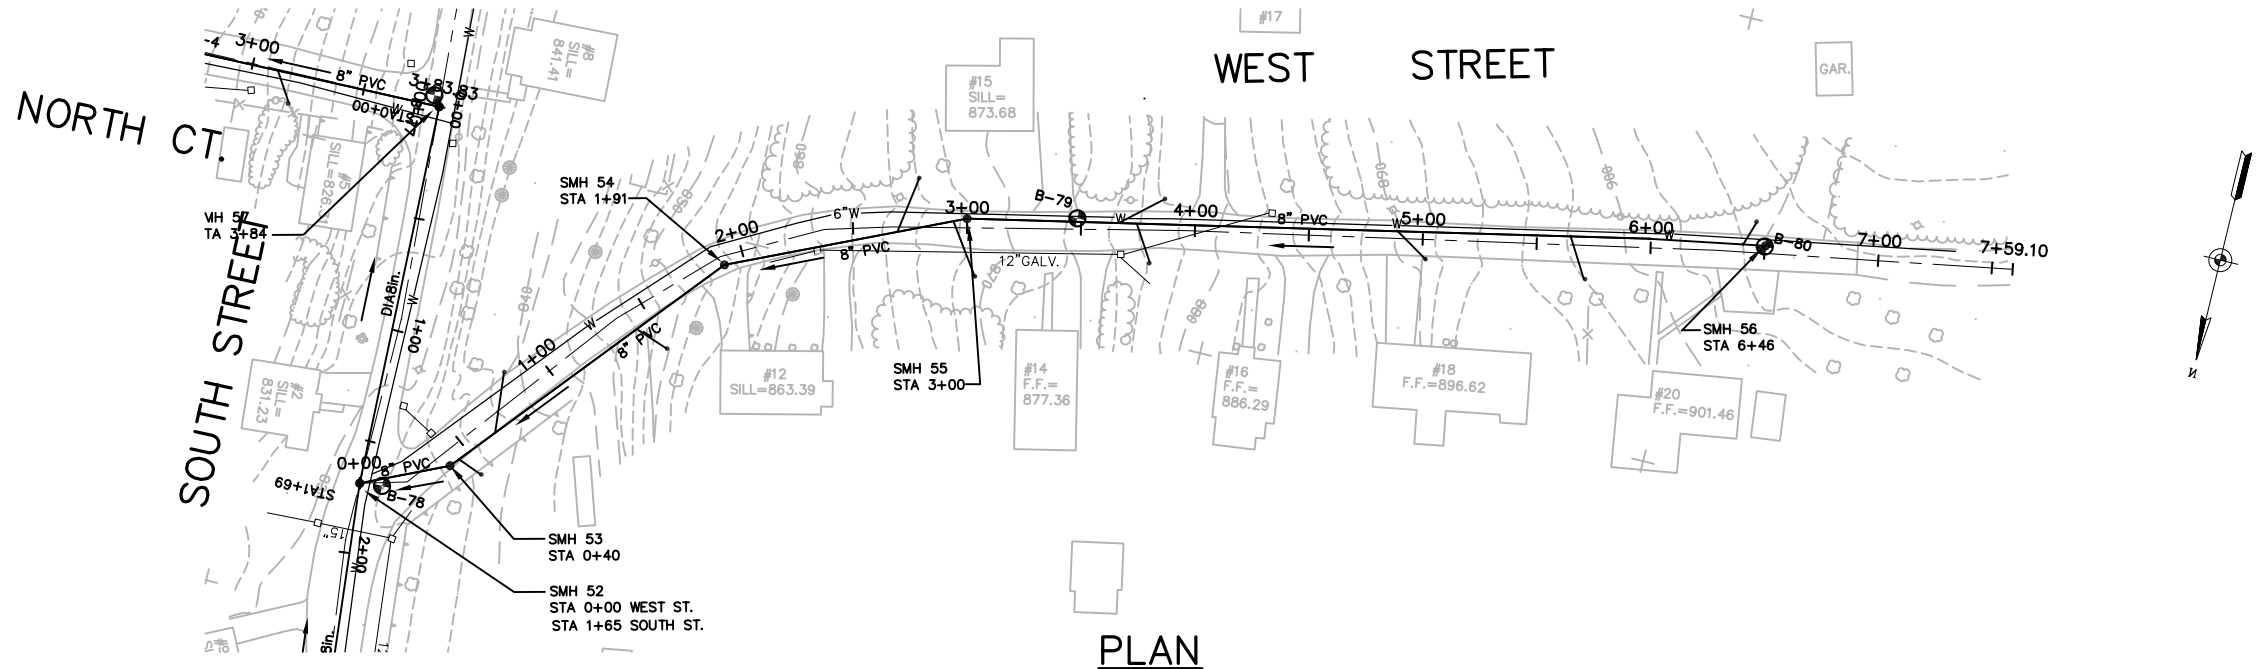


## PROFILE

SCALE: 1"=40' HORZ.
1"=4' VERT.

## "AS-BUILT"

I HEREBY CERTIFY THAT TO THE BEST OF MY KNOWLEDGE, BASED UPON CONSTRUCTION RECORDS PROVIDED BY THE RESIDENT ENGINEER AND THE CONTRACTOR, ALL WORK SHOWN ON THIS DRAWING HAS BEEN COMPLETED AS SHOWN.

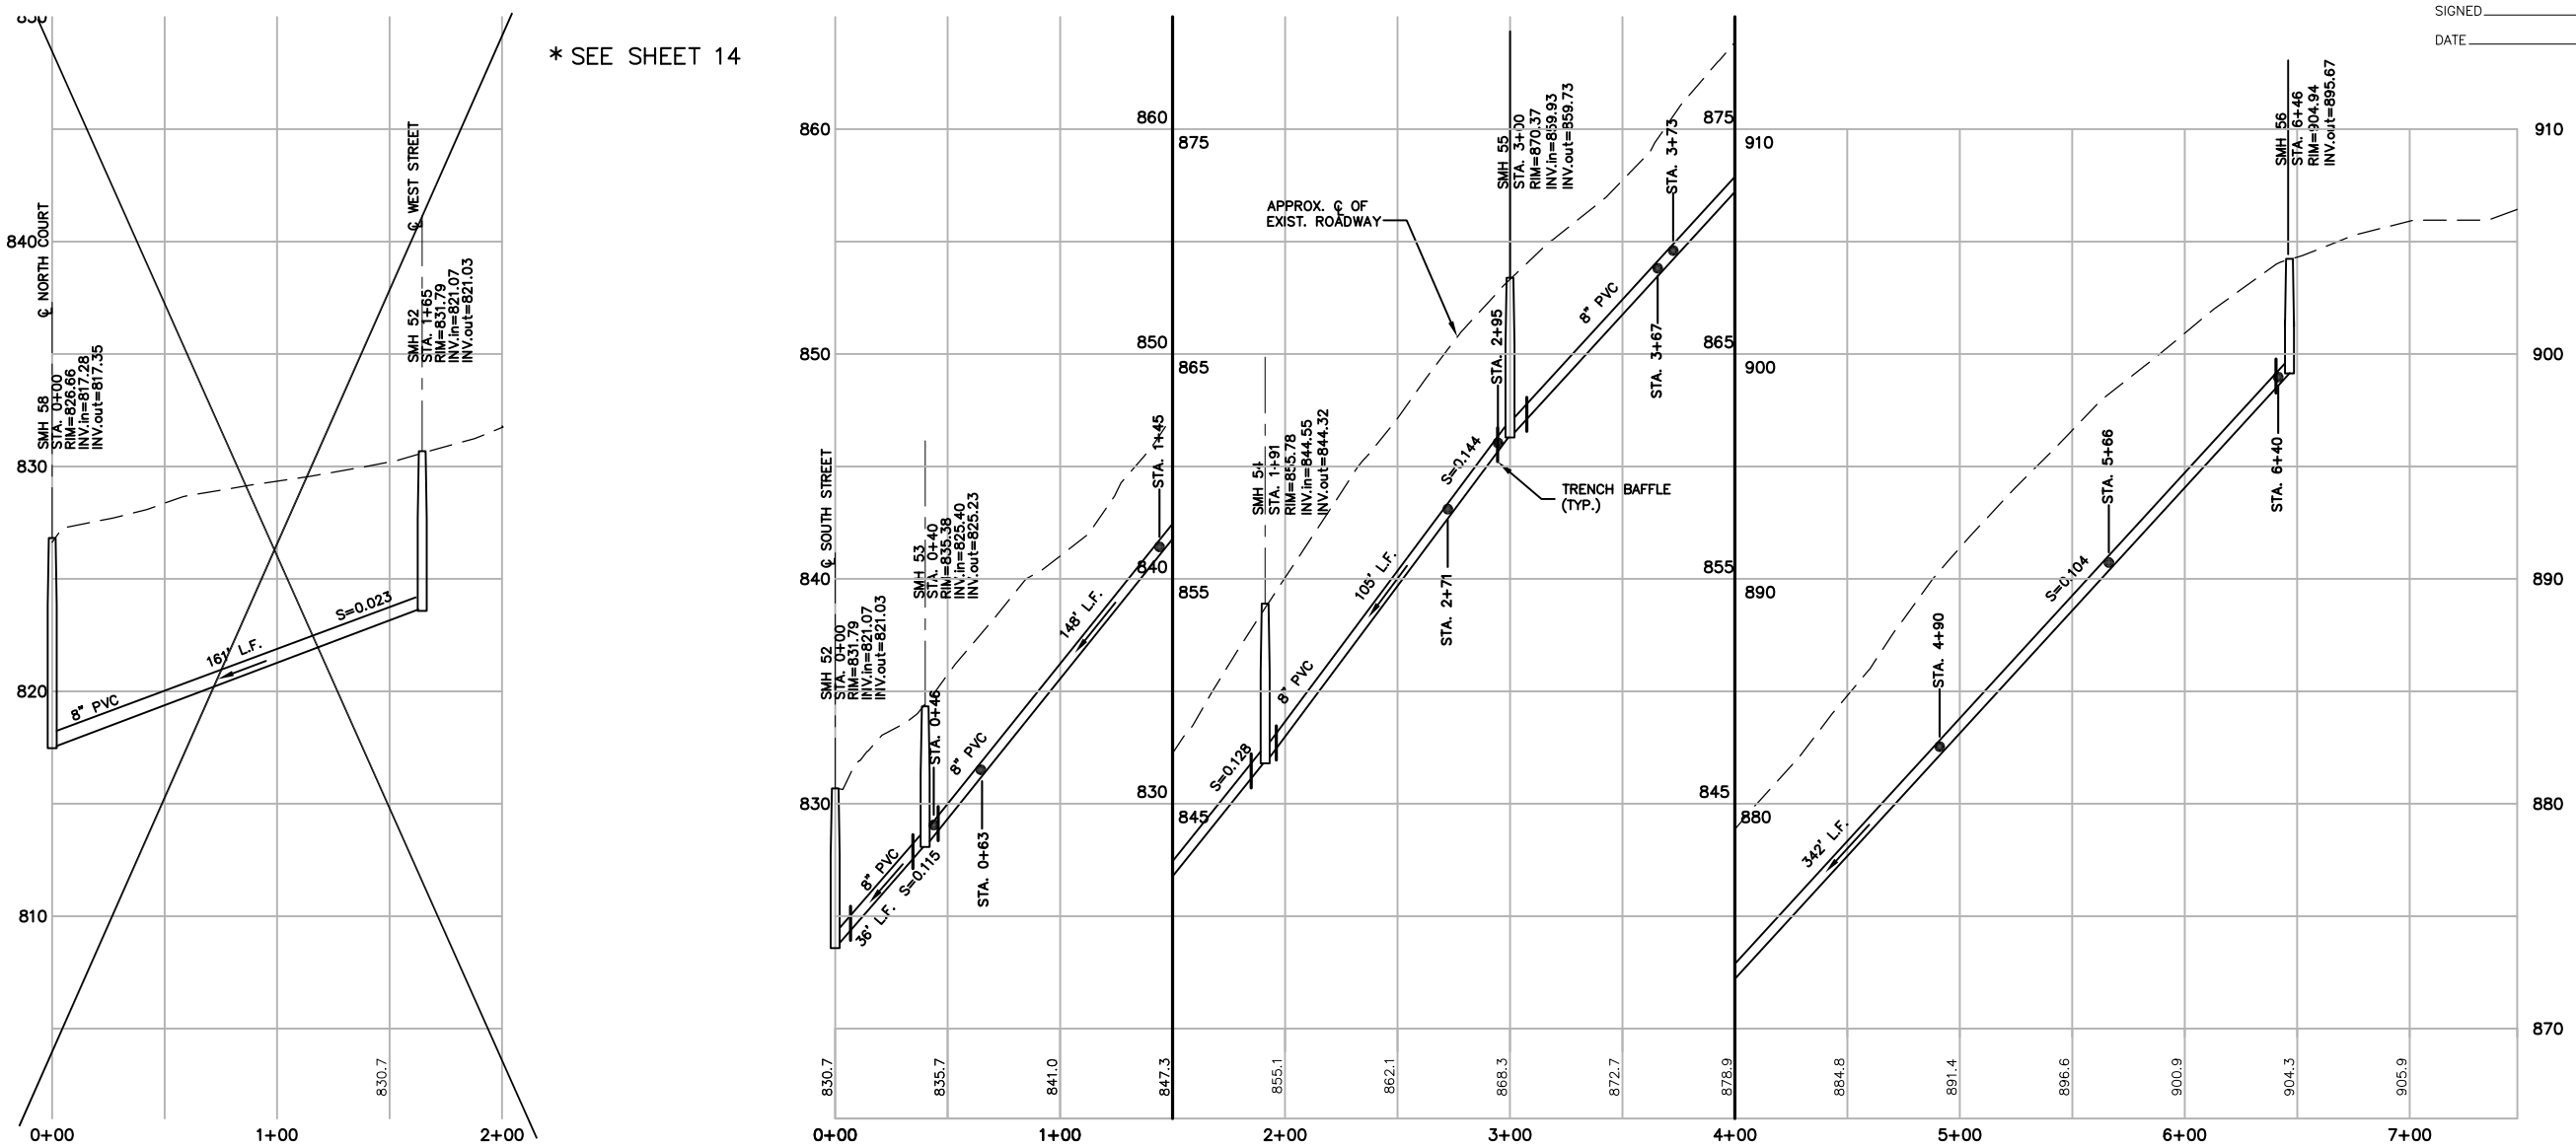HOYLE, TANNER & ASSOCIATES, INC.

SIGNED _____

DATE _____

ENGINEER/ARCHITECT

| REV. | DESCRIPTION | DR. BY | CHKD. BY | APPD. BY | DATE |
|---|---|---|---|---|---|
| 1. | AS-BUILTS | C.B. | J.H. | J.H. | 10/00 |

PROJECT NO. 105707

FILE NAME AB105P16

DO NOT SCALE DRAWING

HTA Hoyle, Tanner & Associates, Inc.
Consulting Engineers
150 Dow Street • Manchester • New Hampshire 03101

DES. BY JAH | DR. BY RCP | CHKD. BY NLT

SCALE: AS SHOWN | DATE: APRIL 2000

CHERRY VALLEY SEWER DISTRICT
LEICESTER, MASSACHUSETTS

PLAN AND PROFILE

WEST STREET
STA. 0+00 TO 6+00

DRAWING NO. 13

SHEET 13 OF 18